



SHAFT HOUSE PUEBLITO

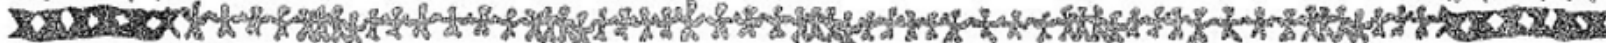

CROW CANYON PETROGLYPHS TRASS NH-62
SCALE 1"=60'

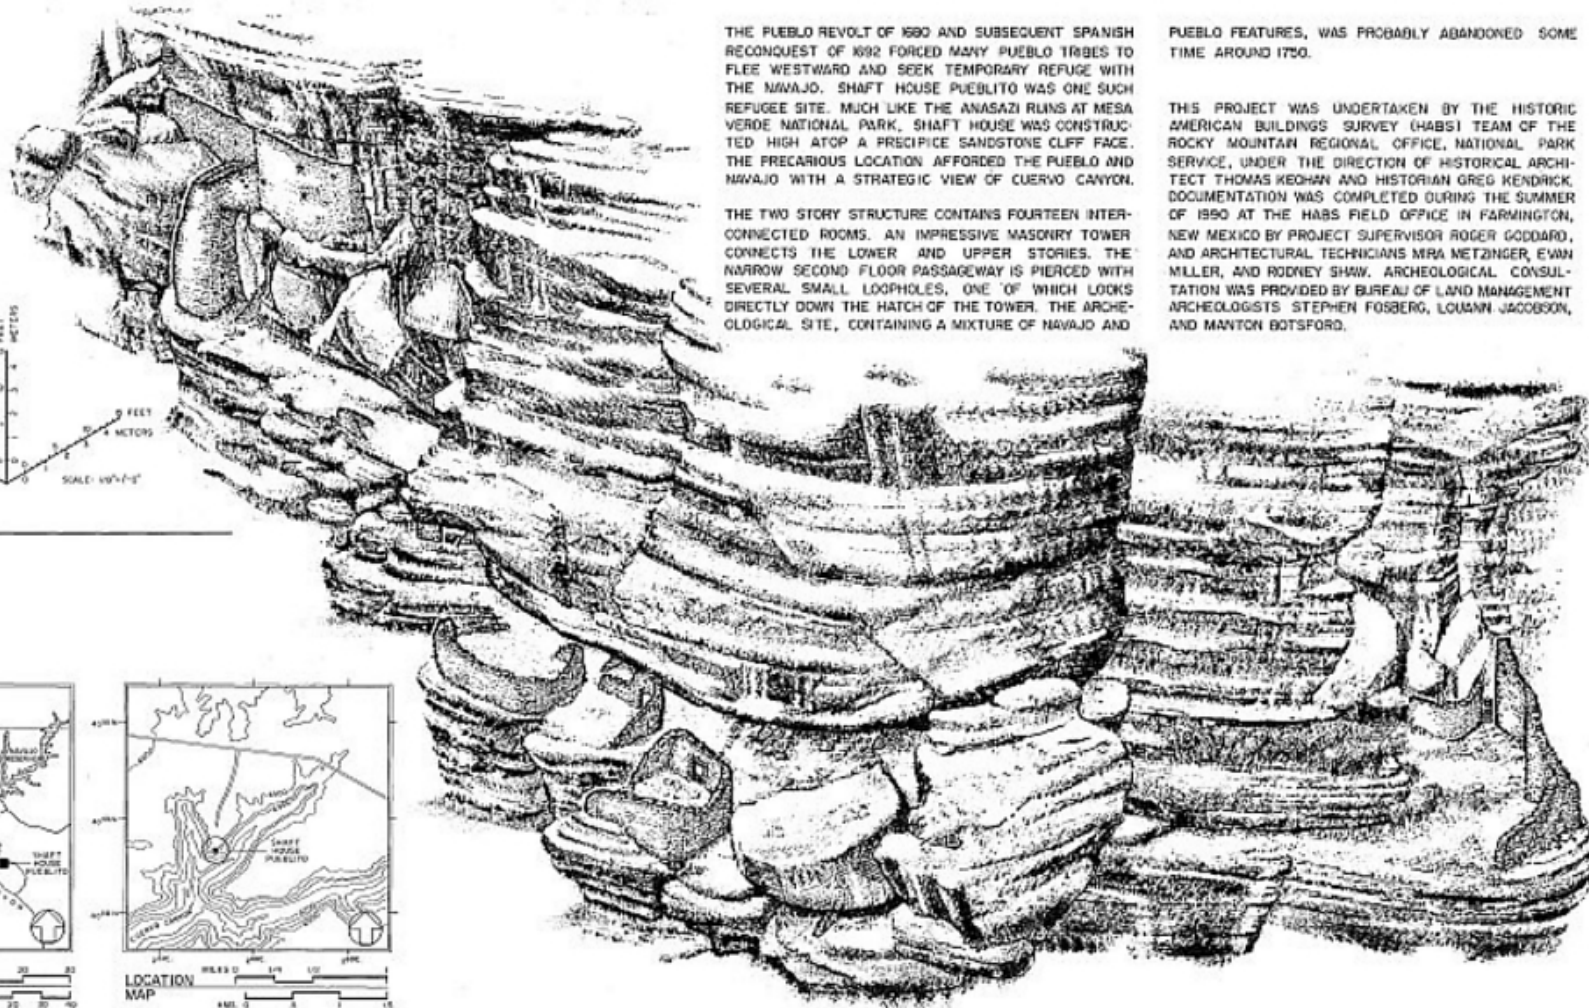


THE PUEBLO REVOLT OF 1680 AND SUBSEQUENT SPANISH RECONQUEST OF 1692 FORCED MANY PUEBLO TRIBES TO FLEE WESTWARD AND SEEK TEMPORARY REFUGE WITH THE NAVAJO. SHAFT HOUSE PUEBLITO WAS ONE SUCH REFUGEE SITE. MUCH LIKE THE ANASAZI RUINS AT MESA VERDE NATIONAL PARK, SHAFT HOUSE WAS CONSTRUCTED HIGH ATOP A PRECIPICE SANDSTONE CLIFF FACE. THE PRECARIOUS LOCATION AFFORDED THE PUEBLO AND NAVAJO WITH A STRATEGIC VIEW OF CUERVO CANYON.

THE TWO STORY STRUCTURE CONTAINS FOURTEEN INTERCONNECTED ROOMS. AN IMPRESSIVE MASONRY TOWER CONNECTS THE LOWER AND UPPER STORIES. THE NARROW SECOND FLOOR PASSAGEWAY IS PIERCED WITH SEVERAL SMALL LOOPHOLES, ONE OF WHICH LOOKS DIRECTLY DOWN THE HATCH OF THE TOWER. THE ARCHEOLOGICAL SITE, CONTAINING A MIXTURE OF NAVAJO AND

PUEBLO FEATURES, WAS PROBABLY ABANDONED SOME TIME AROUND 1700.

THIS PROJECT WAS UNDERTAKEN BY THE HISTORIC AMERICAN BUILDINGS SURVEY (HABS) TEAM OF THE ROCKY MOUNTAIN REGIONAL OFFICE, NATIONAL PARK SERVICE, UNDER THE DIRECTION OF HISTORICAL ARCHITECT THOMAS KEOHAN AND HISTORIAN GREG KENDRICK. DOCUMENTATION WAS COMPLETED DURING THE SUMMER OF 1990 AT THE HABS FIELD OFFICE IN FARMINGTON, NEW MEXICO BY PROJECT SUPERVISOR ROGER GODDARD, AND ARCHITECTURAL TECHNICIANS MIRA METZINGER, EVAN MILLER, AND RODNEY SHAW. ARCHEOLOGICAL CONSULTATION WAS PROVIDED BY BUREAU OF LAND MANAGEMENT ARCHEOLOGISTS STEPHEN FOSBERG, LOUANN JACOBSON, AND MANTON BOTSFORD.

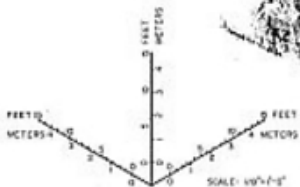

ISOMETRIC VIEW
LOOKING NORTHWEST




REGION
MAP



LOCATION
MAP


HISTORIC AMERICAN BUILDINGS SURVEY
SERIES 1 OF 5 SHEETS
NOV 1991
NEW MEXICO
SHAFT HOUSE PUEBLITO
BLAKE VICTORY
ROGER E. GODDARD, MIRA D. METZINGER, AND EVAN F. MILLER 1990
ROCKY MOUNTAIN REGIONAL OFFICE / DENVER
NATIONAL PARK SERVICE

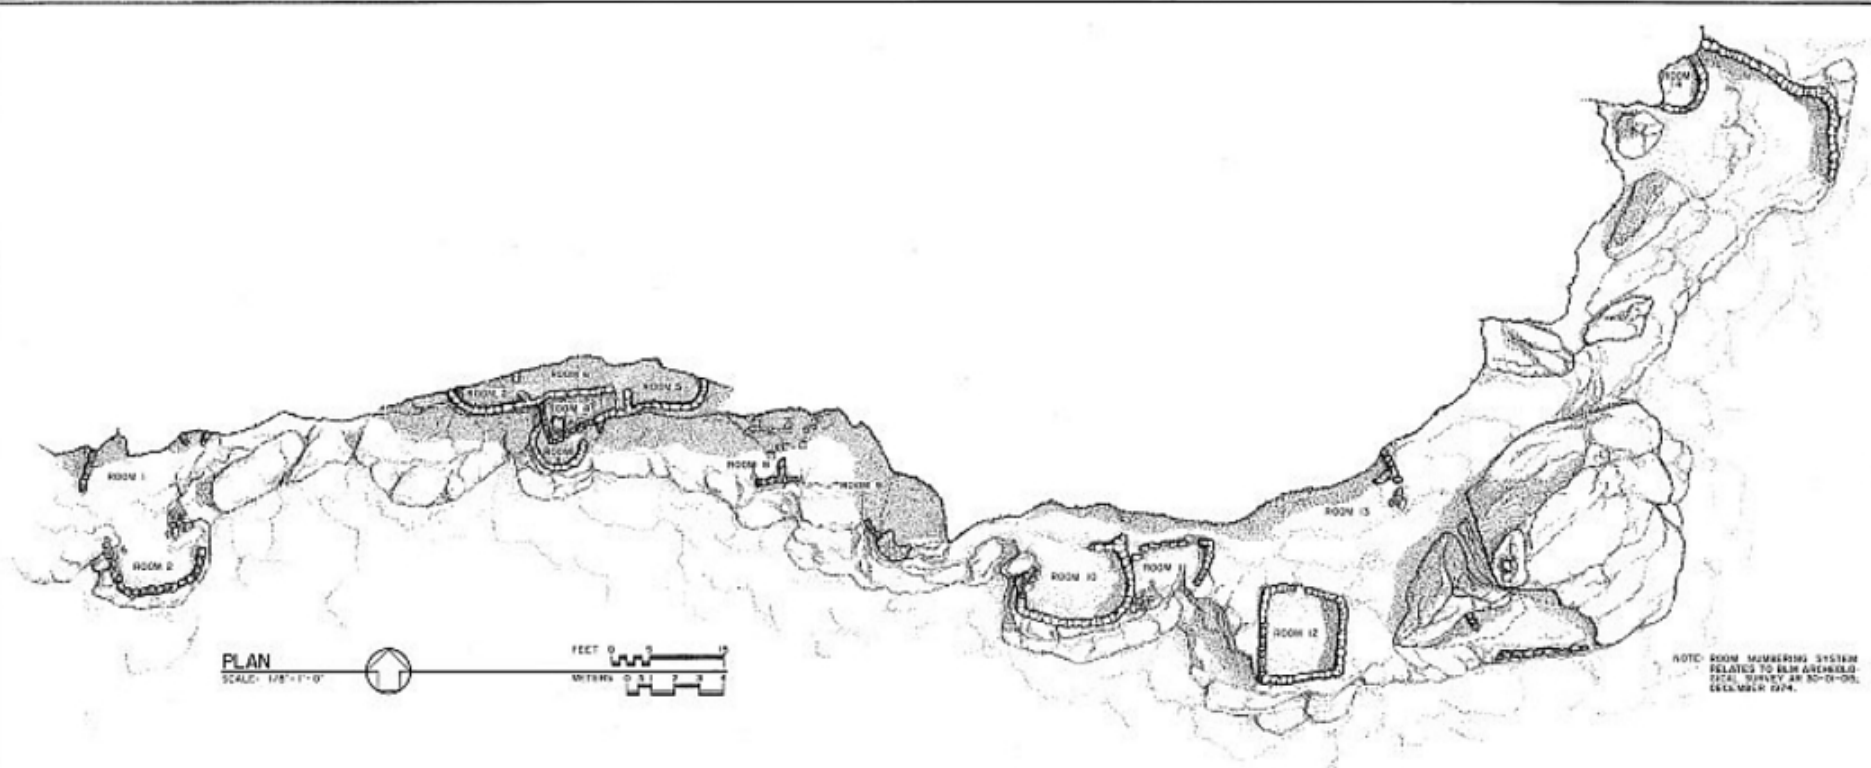


PLAN
SCALE: 1/8" = 1'-0"




NOTE: ROOM NUMBERING SYSTEM RELATED TO 1956 GREENHOLD TOTAL SURVEY AND 20-01-06L, SEE MAPS 2274.

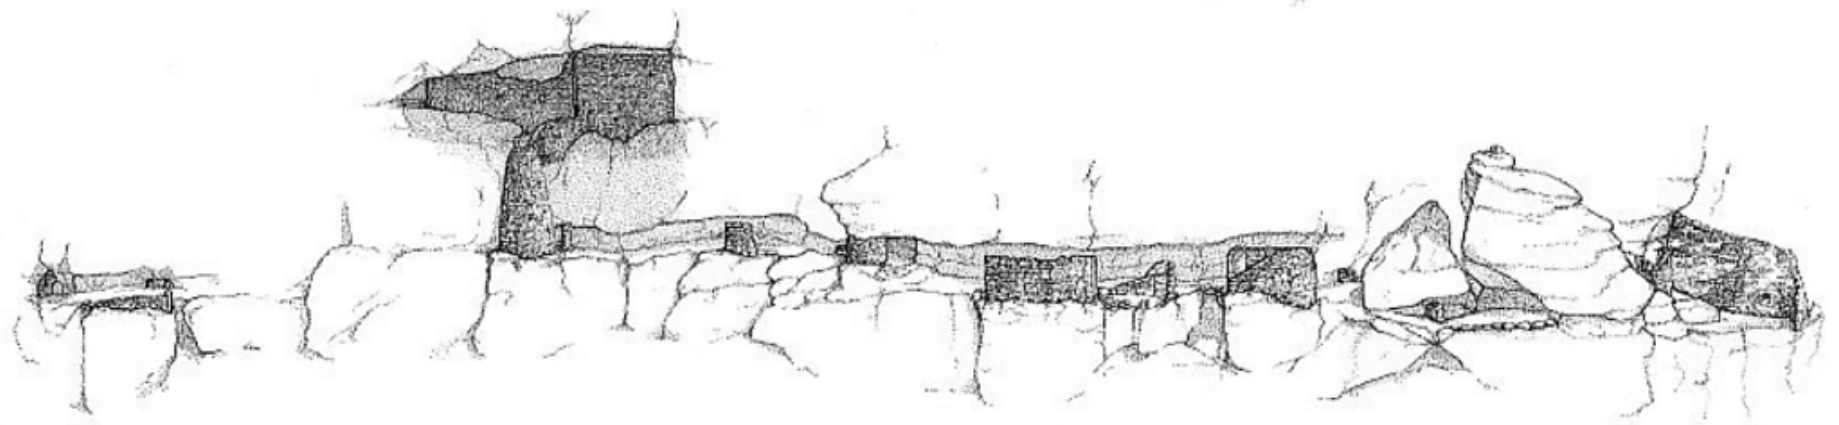

SOUTH ELEVATION
SCALE: 1/8" = 1'-0"

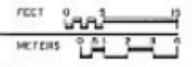

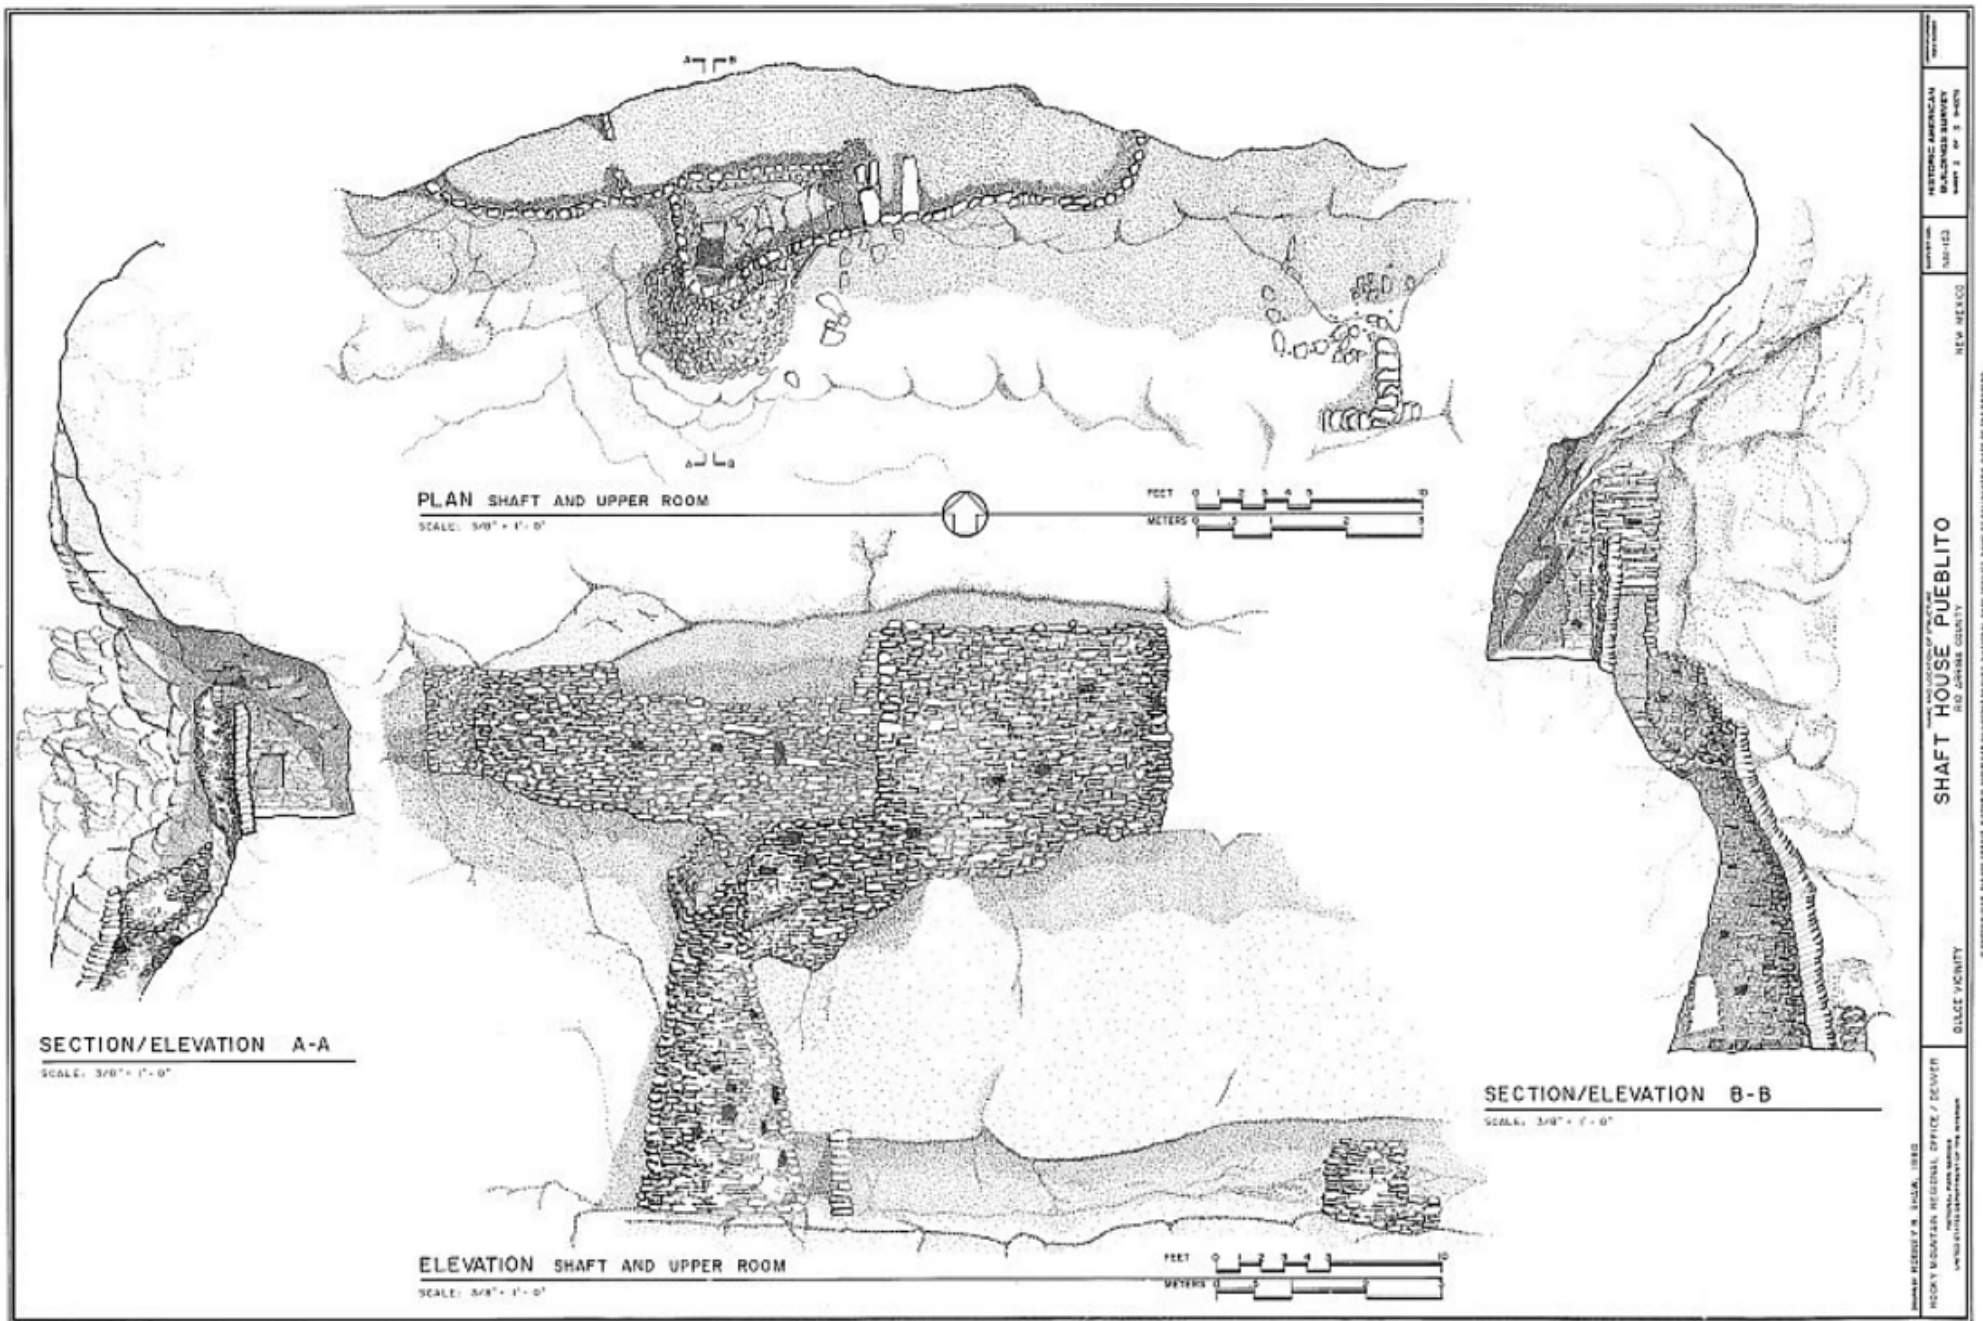

HISTORIC AMERICAN BUILDINGS SURVEY
 NUMBER 2 OF 3 SHEETS
 SURVEY NO. 140-123
 NEW MEXICO
 SHAFT HOUSE PUEBLITO
 RIO ARriba COUNTY
 DULCE VICINITY
 PHOTOGRAPHER: HENRY W. HALL, 1933
 DRAWN BY: HENRY W. HALL, 1933
 REPRODUCED FROM THE ARCHIVES OF THE HISTORIC AMERICAN BUILDINGS SURVEY, NATIONAL ARCHIVES, COLLEGE PARK, MARYLAND. NAME OF DRAWING: SHAFT HOUSE PUEBLITO.

Reference
 Historic American Buildings Survey, C., Pueblo Indians, Navajo Indians, Fosberg, S., Jacobson, L., Botsford, M. [...] Shaw, R. B., Thallheimer, A., photographer. (1933) *Shaft House Pueblito, Cuervo Canyon, Dulce, Rio Arriba County, NM*. Dulce New Mexico Rio Arriba County, 1933. Documentation Compiled After. [Drawings] Retrieved from the Library of Congress, <https://www.loc.gov/item/nm0160/>.